

TO: CHRIS NOURY

I HEREBY CERTIFY THAT THIS MAP AND THE FIELD SURVEY ON WHICH IT IS BASED, TO THE BEST OF MY KNOWLEDGE, INFORMATION & BELIEF AND IN MY PROFESSIONAL OPINION, COMPLIES WITH THE REQUIREMENTS FOR A (CLASS A) URBAN LAND SURVEY AS SET FORTH IN THE "MINIMUM STANDARDS MANUAL FOR THE PRACTICE OF LAND SURVEYING IN SOUTH CAROLINA" CODE OF LAWS OF SOUTH CAROLINA, CHAPTER 22, SECTION 40-22-5 THROUGH 40-22-320. I FURTHER CERTIFY THAT THE AREA WAS DETERMINED BY THE COORDINATE CROSS MULTIPLICATION METHOD OF CALCULATION. WITNESS MY HAND AND SEAL THIS 9<sup>th</sup> DAY OF August, 2002.



*Les H. Bodkin III*  
LES H. BODKIN III P.L.S. NO. 14182

THIS MAP AND FIELD SURVEY WERE MADE FOR THE EXCLUSIVE USE OF THE PERSON, PERSONS OR ENTITY NAMED IN THE CERTIFICATION HEREON. SAID CERTIFICATION DOES NOT EXTEND OR TRANSFER TO ANY UNNAMED PERSON, PERSONS, OR ENTITY WITHOUT AN EXPRESSED RE-CERTIFICATION BY THE SURVEYOR NAMING SAID PERSON, PERSONS, OR ENTITY.

NOTES:

- 1) TAX MAP NO.: 41-125-86.30.
- 2) DATE OF FIELD SURVEY: AUGUST 8, 2002.
- 3) THIS AREA IS LOCATED IN FLOOD ZONES AE (WITH BASE FLOOD ELEVATION = 13) & VE (WITH BASE FLOOD ELEVATION = 14) AS SHOWN ON PANEL NO. 450085 0166E DATED OCT. 16, 1992 - NATIONAL FLOOD INSURANCE PROGRAM FLOOD INSURANCE RATE MAP.
- 4) ALL BEARINGS ARE BASED ON THE SOUTH CAROLINA STATE PLANE COORDINATE SYSTEM NAD 1983. DISTANCES SHOWN ARE HORIZONTAL DISTANCES NOT GRID DISTANCES.
- 5) THIS SURVEY IS VALID ONLY IF THE PRINT OF SAME HAS THE ORIGINAL SIGNATURE AND EMBOSSED SEAL OF THE SURVEYOR.
- 6) NO TITLE SEARCH WAS PERFORMED BY THIS OFFICE ON THIS DATE.
- 7) THIS LOT IS SUBJECT TO ALL EASEMENTS AND RESTRICTIONS OF RECORD.
- 8) THE OCRM CRITICAL LINE SHOWN HEREON WAS FIELD SURVEYED BY THIS OFFICE FROM A DELINEATION PERFORMED BY PERSONNEL FROM THE OFFICE OF OCEAN & COASTAL RESOURCE MANAGEMENT OFFICE IN AUGUST, 2002.
- 9) DEED REF: D.B. 687, PG. 119.
- 10) FLOOD ZONE LINE SHOWN HEREON IS SCALED FROM NATIONAL FLOOD INSURANCE PROGRAM-FLOOD INSURANCE RATE MAP NOTED ABOVE. THE SCALE OF THE MAP IS LABELED APPROXIMATE AND SURVEY TECHNOLOGY, INC. ASSUMES NO RESPONSIBILITY OR GUARANTEE TO THE ACCURACY OF THE LINE SHOWN HEREON.


1/27.P.F.  
N 625326.8  
E 2593189.1  
GRID (NAD 83)

GEORGE N. MACGRATH, JR.  
41-125-93  
D.B. 536, PG. 286  
P.B. F, PG. 152

LEGEND

- I.P.F. IRON PIPE FOUND
- R.F. REBAR FOUND
- C.P. COMPUTED POINT
- PT PROPANE TANK
- PP POWER POLE
- WM WATER METER
- SCO SEWER CLEAN-OUT
- CONC. CONCRETE
- R.O.D. REGISTER OF DEEDS

I, LES H. BODKIN III, HEREBY CERTIFY THAT THIS SURVEY IS A RESURVEY OF AN EXISTING LOT OF RECORD WITH NO BOUNDARY CHANGES WHATSOEVER AND RECORDED AT THE HORRY COUNTY R.O.D. OFFICE IN P.B. 66, PG. 009B.

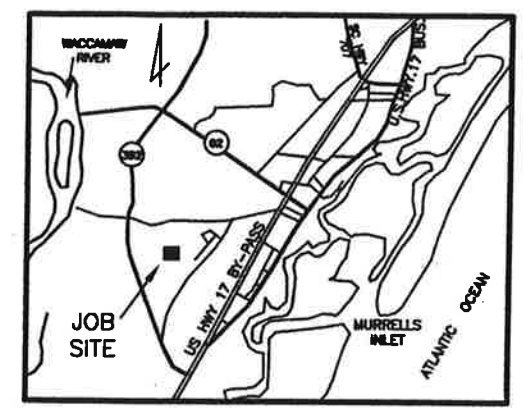

VICINITY MAP  
SCALE 1" = 2 miles

LOT 4  
MARTIN H. DURHAM  
41-125-86.29  
D.B. 821, PG. 066  
P.B. 066, PG. 009B  
CERTIFICATE OF APPROVAL FOR RECORDING

I hereby certify that the subdivision plat shown here has been found to comply with the Land Development regulations for Georgetown County, South Carolina, with the exception of a minor variance, if any, as are noted in the minutes of the Planning Commission and that it has been approved for recording in the office of the Register of Deeds.

Dated 08/15/02

*Robert H. Bodkin III*  
Chairman, Planning Commission

| LINE | BEARING       | DISTANCE |
|------|---------------|----------|
| L1   | N 34°10'38" E | 2.59     |
| L2   | N 72°21'24" W | 35.21    |
| L3   | N 72°21'24" W | 14.24    |
| L4   | N 49°23'07" E | 10.03    |
| L5   | N 87°27'39" E | 10.81    |
| L6   | S 55°17' W    | 13.73    |

|                          |                   |
|--------------------------|-------------------|
| AREA ABOVE CRITICAL LINE | 6820 S.F.±        |
| AREA BELOW CRITICAL LINE | 2199 S.F.±        |
| <b>TOTAL LOT AREA</b>    | <b>9019 S.F.±</b> |

AS-BUILT SURVEY OF LOT 5  
FITZ COKER SUBDIVISION  
FOR CHRIS NOURY

MURRELLS INLET TOWNSHIP 7  
GEORGETOWN COUNTY SOUTH CAROLINA  
SCALE 1" = 20 FEET AUGUST 9, 2002



SURVEYED AND MAPPED BY  
**SURVEY TECHNOLOGY, INC.**  
MURRELLS INLET, GEORGETOWN COUNTY  
SOUTH CAROLINA 29576  
843-651-8656

REFERENCE MAP ENTITLED "SURVEY OF LOT 5 FOR FITZ COKER" BY SUR-TECH, INC. DATED AUG. 21, 1992.